
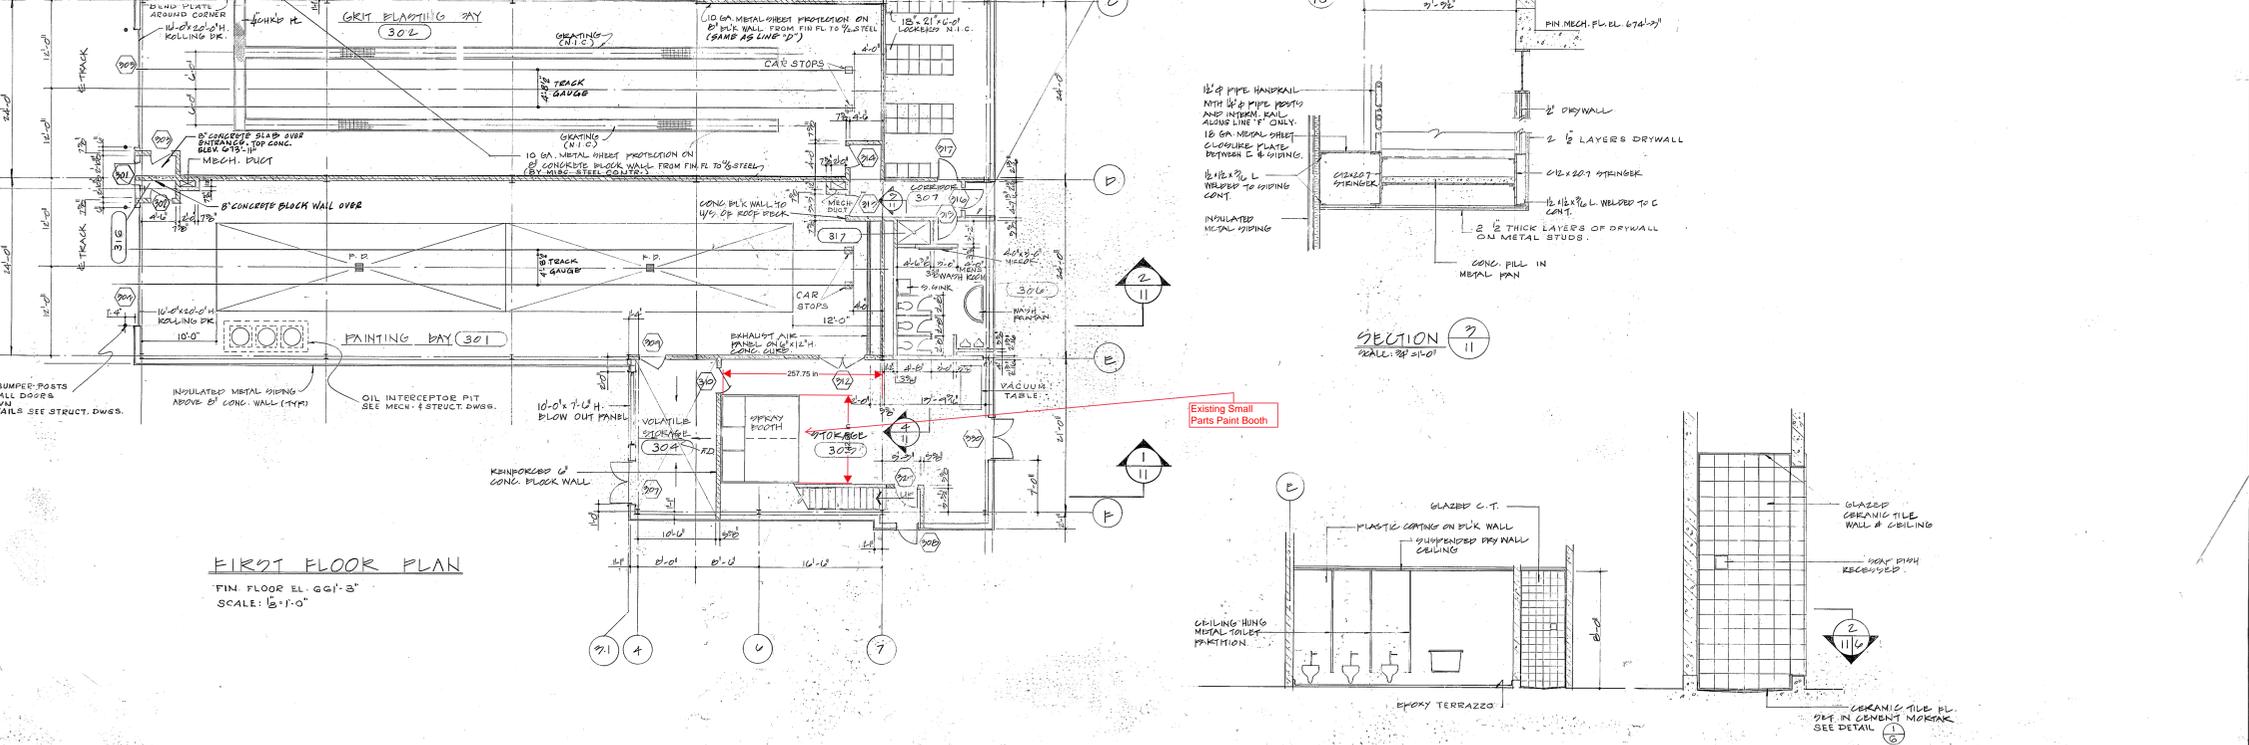
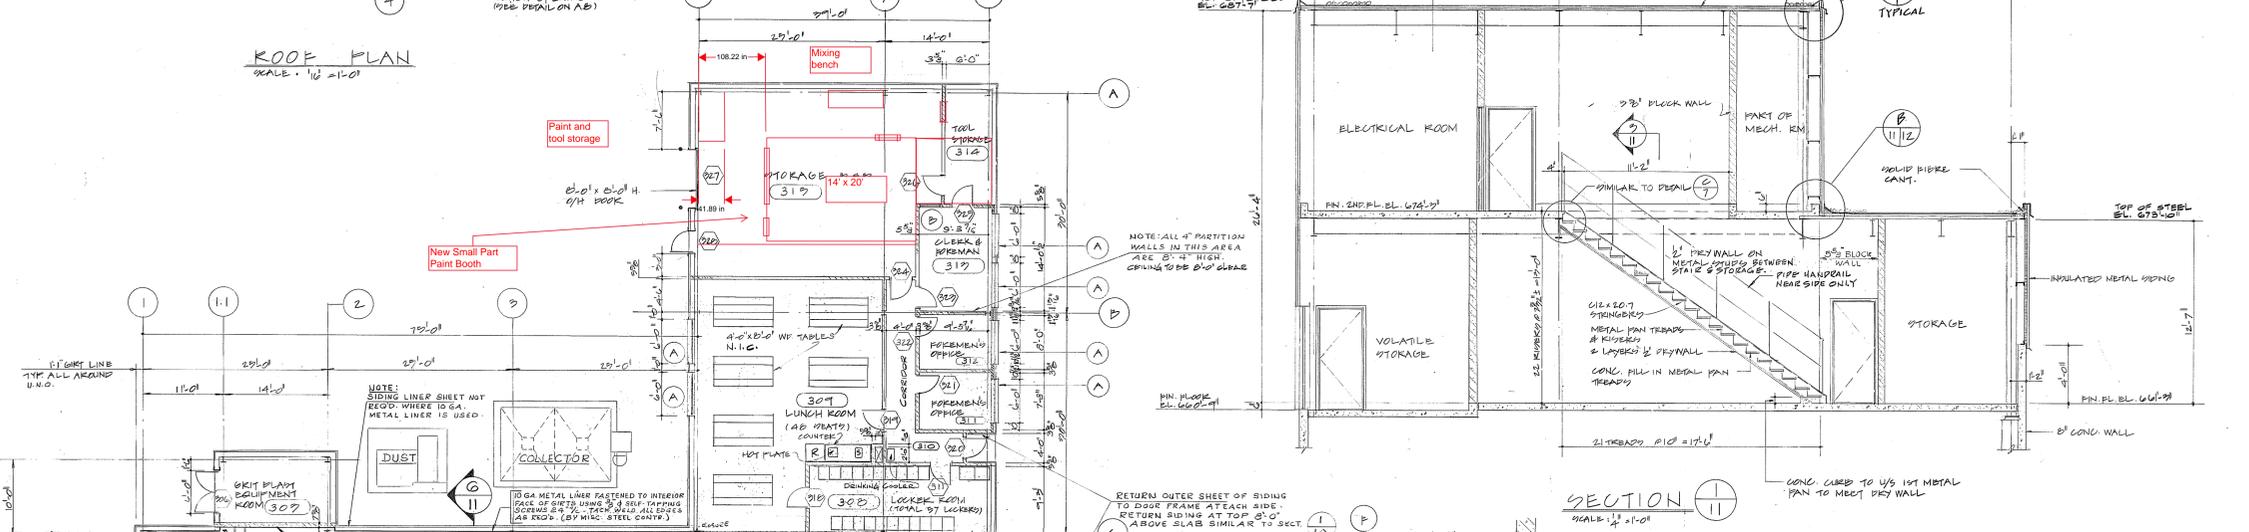


## **Project 3: Small Parts Spray Booth**

notes and reference drawings  
 ALL BLOCK WALLS SHALL BE 4" NOMINAL UNLESS NOTED OTHERWISE.  
 FOR LOCATIONS & SIZES OF ROOF OPENINGS REFER MECHANICAL DWGS.

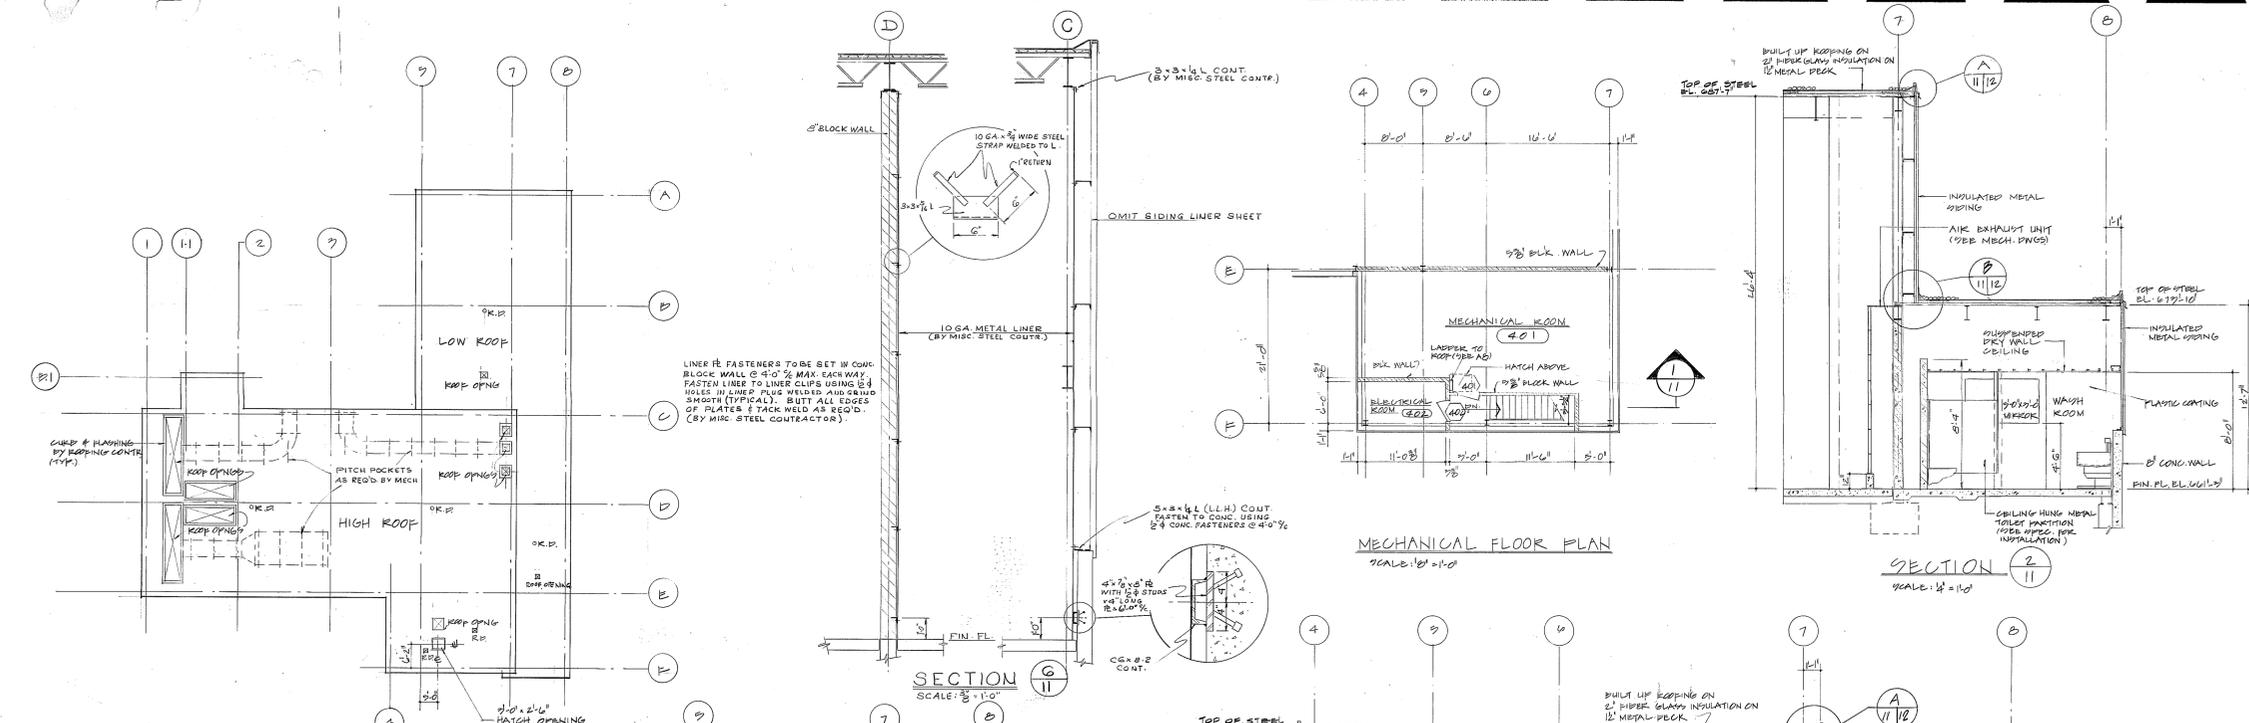

C	REV. 7/89	AS BUILT					
D	10-5-74	REVISED DRAWING VOLTAGE AREA. SOME CONCRETE AND MASONRY WALLS AND 8" IN POSSIBLE OFFICE CORPERS. ISSUED FOR CONTRACT N					
A	10-5-74	ISSUED FOR GENERAL CONTRACT TENDER					
no.	date	description	issued	checked	approved		

T. J. SHERMAN  
 ARCHITECT  
 PROFESSIONAL ENGINEER  
 PROVINCE OF ONTARIO

**COLE, SHERMAN & ASSOC. LIMITED**  
 TORONTO, ONTARIO

**ONTARIO NORTHLAND RAILWAY**  
**NORTH BAY YARD**  
**CONSOLIDATION OF REPAIR FACILITIES**

**PAINT SHOP**

**ARCHITECTURAL**

drawing title  
**FLOOR AND ROOF PLAN, ELEVATION, SECTIONS AND DETAILS**

designed by	D.Y.	checked by	F.N.	date	
drawn by	D.Y.	approved by	T.J.S.		MARCH, 74
scale	AS SHOWN	draw. status	drawing number		
project number			5473-A11		
	5473				